




REV.	REV. DATE	CHK. BY	CHK. DATE	ENG.	DESCRIPTION
09	07NOV02	DP	07NOV02	DP	REVISED DRAWING TO MAKE IT AS BUILT

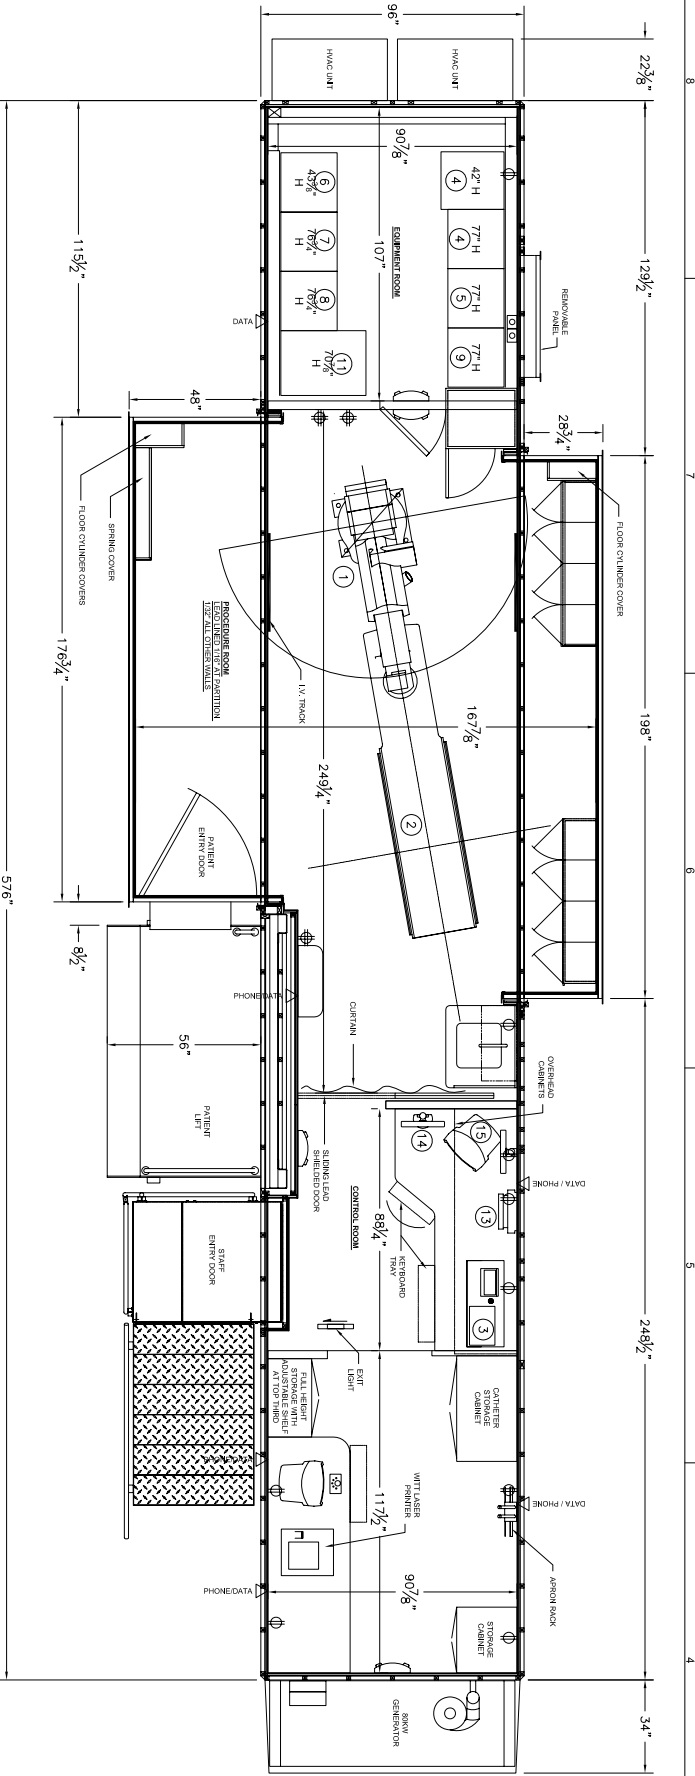



TOP PLAN VIEW

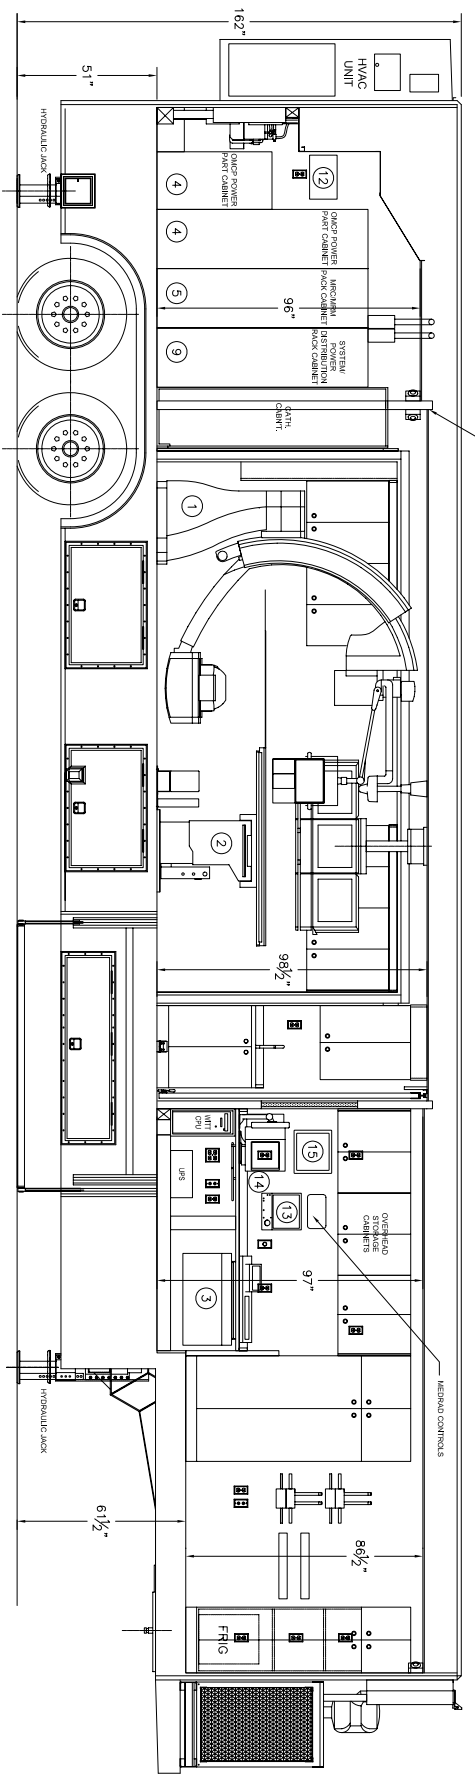

LEFT SIDE VIEW

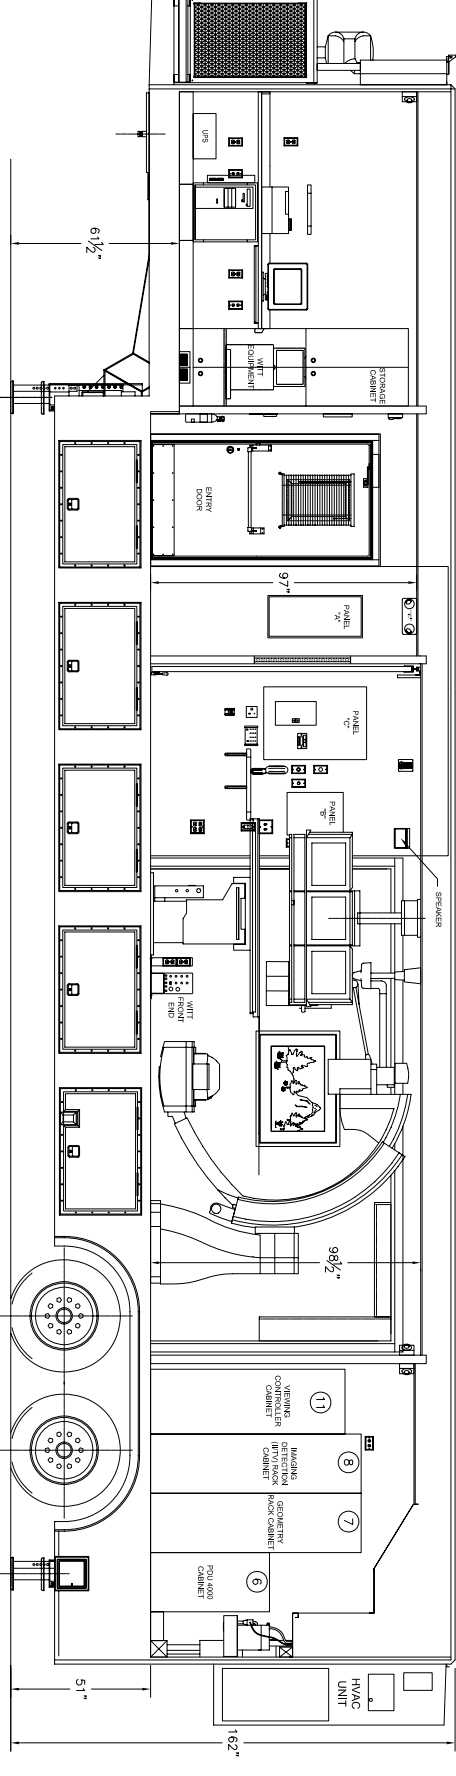

RIGHT SIDE VIEW

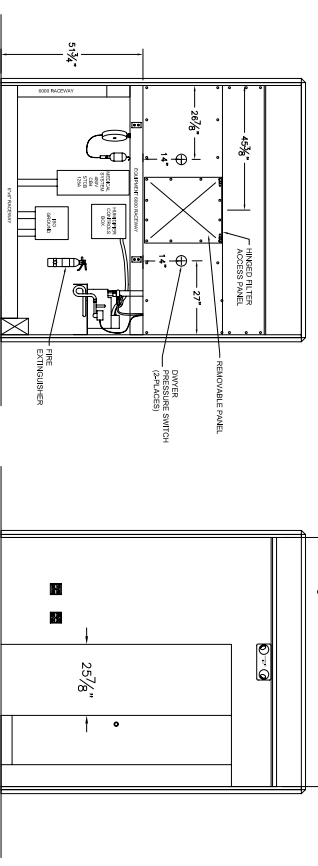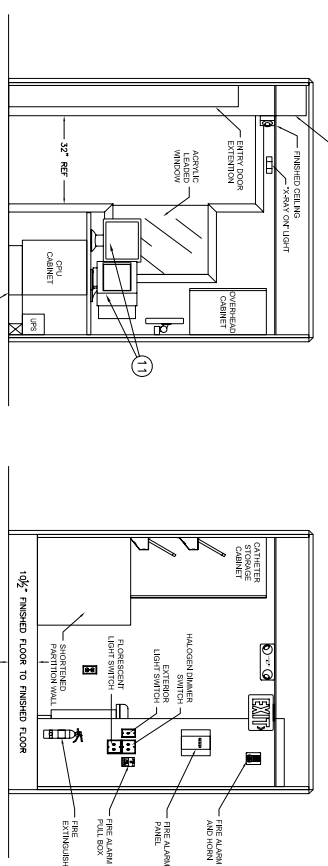

PARTITION WALL VIEWS

ITEM	QTY	PART NUMBER	DESCRIPTION
14	1		WITT PHYSIOLOGICAL RECORDING SYSTEM
13	1		ACQUISITION CONSOLE C/VN
12	1		MEDRAD INJECTOR CONTROL BOX
11	1		VIEWING CONTROLLER CABINET
10	1		VISUB VIEWING CONSOLE
9	1		SYSTEM/POWER DISTRIBUTION RACK CABINET
8	1		IMAGING DETECTION (IITV) RACK CABINET
7	1		GEOMETRY RACK CABINET
6	1		PDU 4000 CABINET
5	1		MRC/MRM RACK CABINET
4	1		OMCP POWER PART CABINET
3	1		DESK TOP VIEWING CONSOLE
2	1		ANGIO DIAGNOST 5 WITH SWIVEL PATIENT TABLE
1	1		FLOOR CLEAT

BILL OF MATERIALS

THIS DRAWING IS PROVIDED ON A CONFIDENTIAL BASIS SUBJECT TO RETURN ON DEMAND OF OSHKOSH SPECIALTY VEHICLES (OSHKOSH), WHICH RETAINS ALL RIGHTS ASSOCIATED WITH IT AND THE ARTICLE OR ARTICLES IT REPRESENTS. DISCLOSURE, REPRODUCTION OR ALTERATION OF ANY PART OF THIS DRAWING OR MANUFACTURE, USE OR SALE OF THE ARTICLE OR ARTICLES REPRESENTED IS PROHIBITED WITHOUT THE PRIOR WRITTEN AUTHORIZATION OF OSHKOSH. © OSHKOSH SPECIALTY VEHICLES (unpublished).

JOB# 1 OF 1

REFERENCE DRAWING: TITLE: GENERAL LAYOUT PHILIPS H3000 PDU 5 PATH LAB 8-31 X 13-95 S 49-01 TRAILER

DATE: 23OCT02 **SCALE:** 3/8"=1'-0"

DRAWN BY: **CHECKED BY:**

OSHKOSH SPECIALTY VEHICLES 16745 S. LATHROP AVENUE HARVEY, IL 60426 PHONE: (708) 598-5066 FAX: (708) 598-2480 **DRAWING NUMBER:** 12190-A01

CUSTOMER AUTHORIZATION

COMPANY NAME: _____

NAME (PRINT): _____ TITLE: _____

SIGNATURE: _____ DATE: _____