
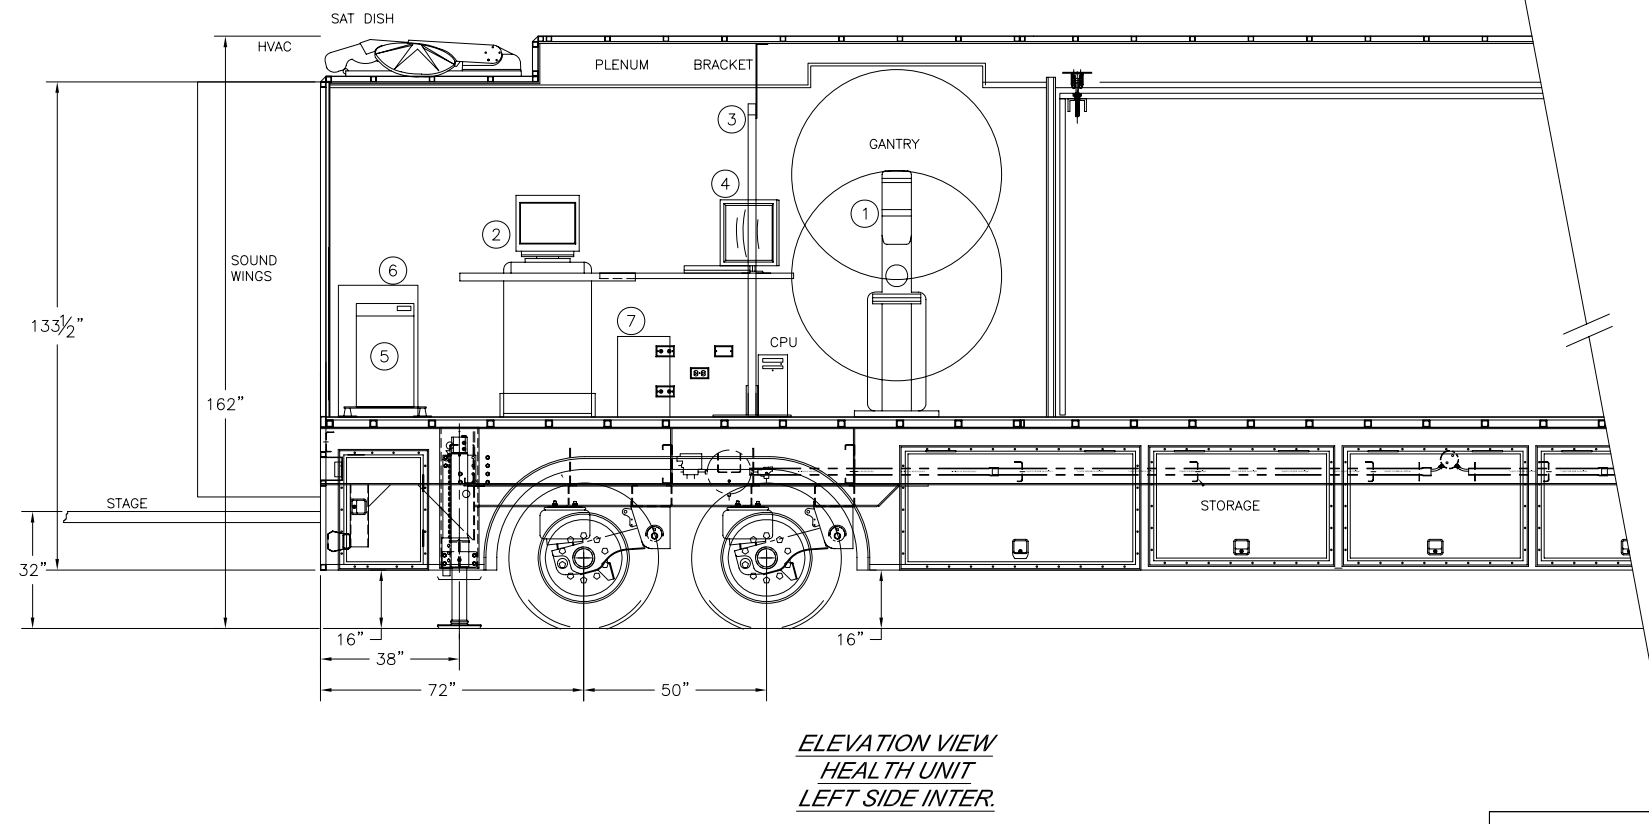


REVISIONS					
REV.	REV. DATE	CHK. BY	CHK. DATE	ENG.	DESCRIPTION
01	19SEP03	W.J.L.	19SEP03	DEK	AS-BUILT

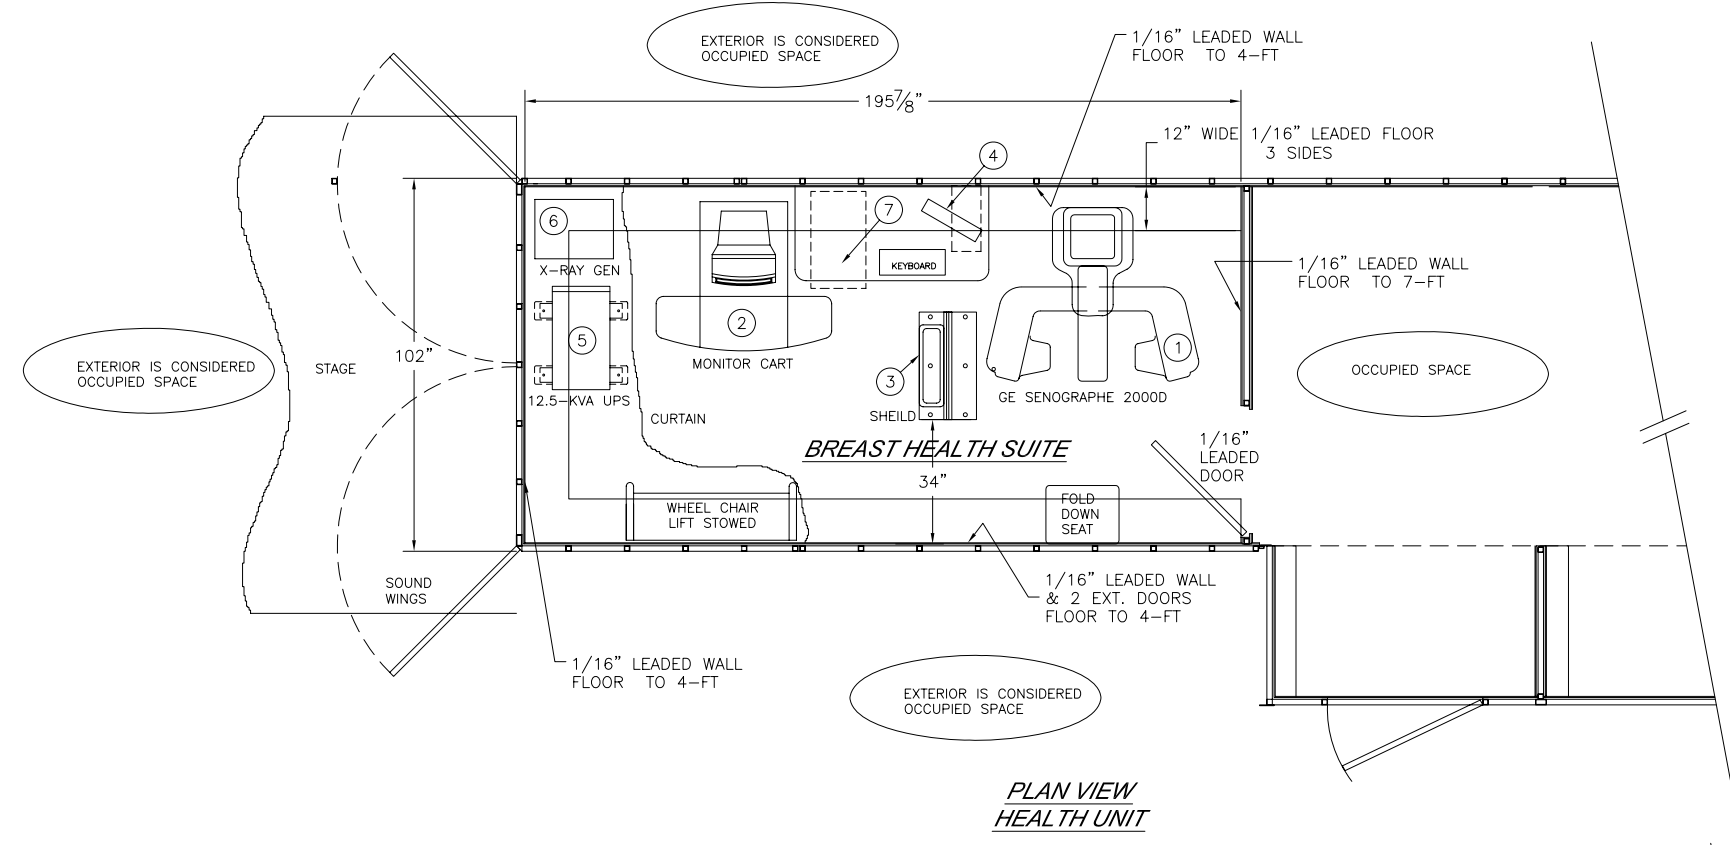

ITEM	QTY	PART NUMBER	DESCRIPTION
7	1		CONDITIONER CABINET
6	1		XRAY GENERATOR CABINET
5	1		UPS (12.5 KVA)
4	1		TDK WORKSTATION
3	1		RADIATION SHIELD & CONTROL CONSOLE
2	1		MONITOR CART
1	1		GANTRY WITH DIGITAL DETECTOR (2000D FFDM)

BILL OF MATERIALS

CUSTOMER AUTHORIZATION

COMPANY NAME: _____

NAME (PRINT): _____ TITLE: _____

SIGNATURE: _____ DATE: _____

THIS DRAWING IS PROVIDED ON A CONFIDENTIAL BASIS SUBJECT TO RETURN ON DEMAND OF OSHKOSH SPECIALTY VEHICLES ("OSHKOSH"), WHICH RETAINS ANY AND ALL RIGHTS ASSOCIATED WITH IT AND THE ARTICLE OR ARTICLES IT REPRESENTS. DISCLOSURE, REPRODUCTION OR ALTERATION OF ANY PART OF THIS DRAWING OR MANUFACTURE, USE OR SALE OF THE ARTICLE OR ARTICLES REPRESENTED, IS PROHIBITED WITHOUT THE PRIOR WRITTEN AUTHORIZATION OF OSHKOSH. © OSHKOSH SPECIALTY VEHICLES (unpublished).

SHEET NUMBER: 1 OF 1	REFERENCE DRAWING:	TITLE: LEAD REQUIREMENTS MOVING EXPERIENCES HEALTH UNIT 8'-6" X 13'-6" X 48'-0" TRAILER	DATE: 02JUN03	SCALE: 1/2"=1'-0"
JOB#		OSHKOSH SPECIALTY VEHICLES	16745 S. LATHROP AVENUE HARVEY, IL. 60426 PHONE: (708) 596-5066 FAX: (708) 596-2480	CHECKED BY: DRAWING NUMBER: 10240-A18